


**1 Hall Plan**  
1 : 100

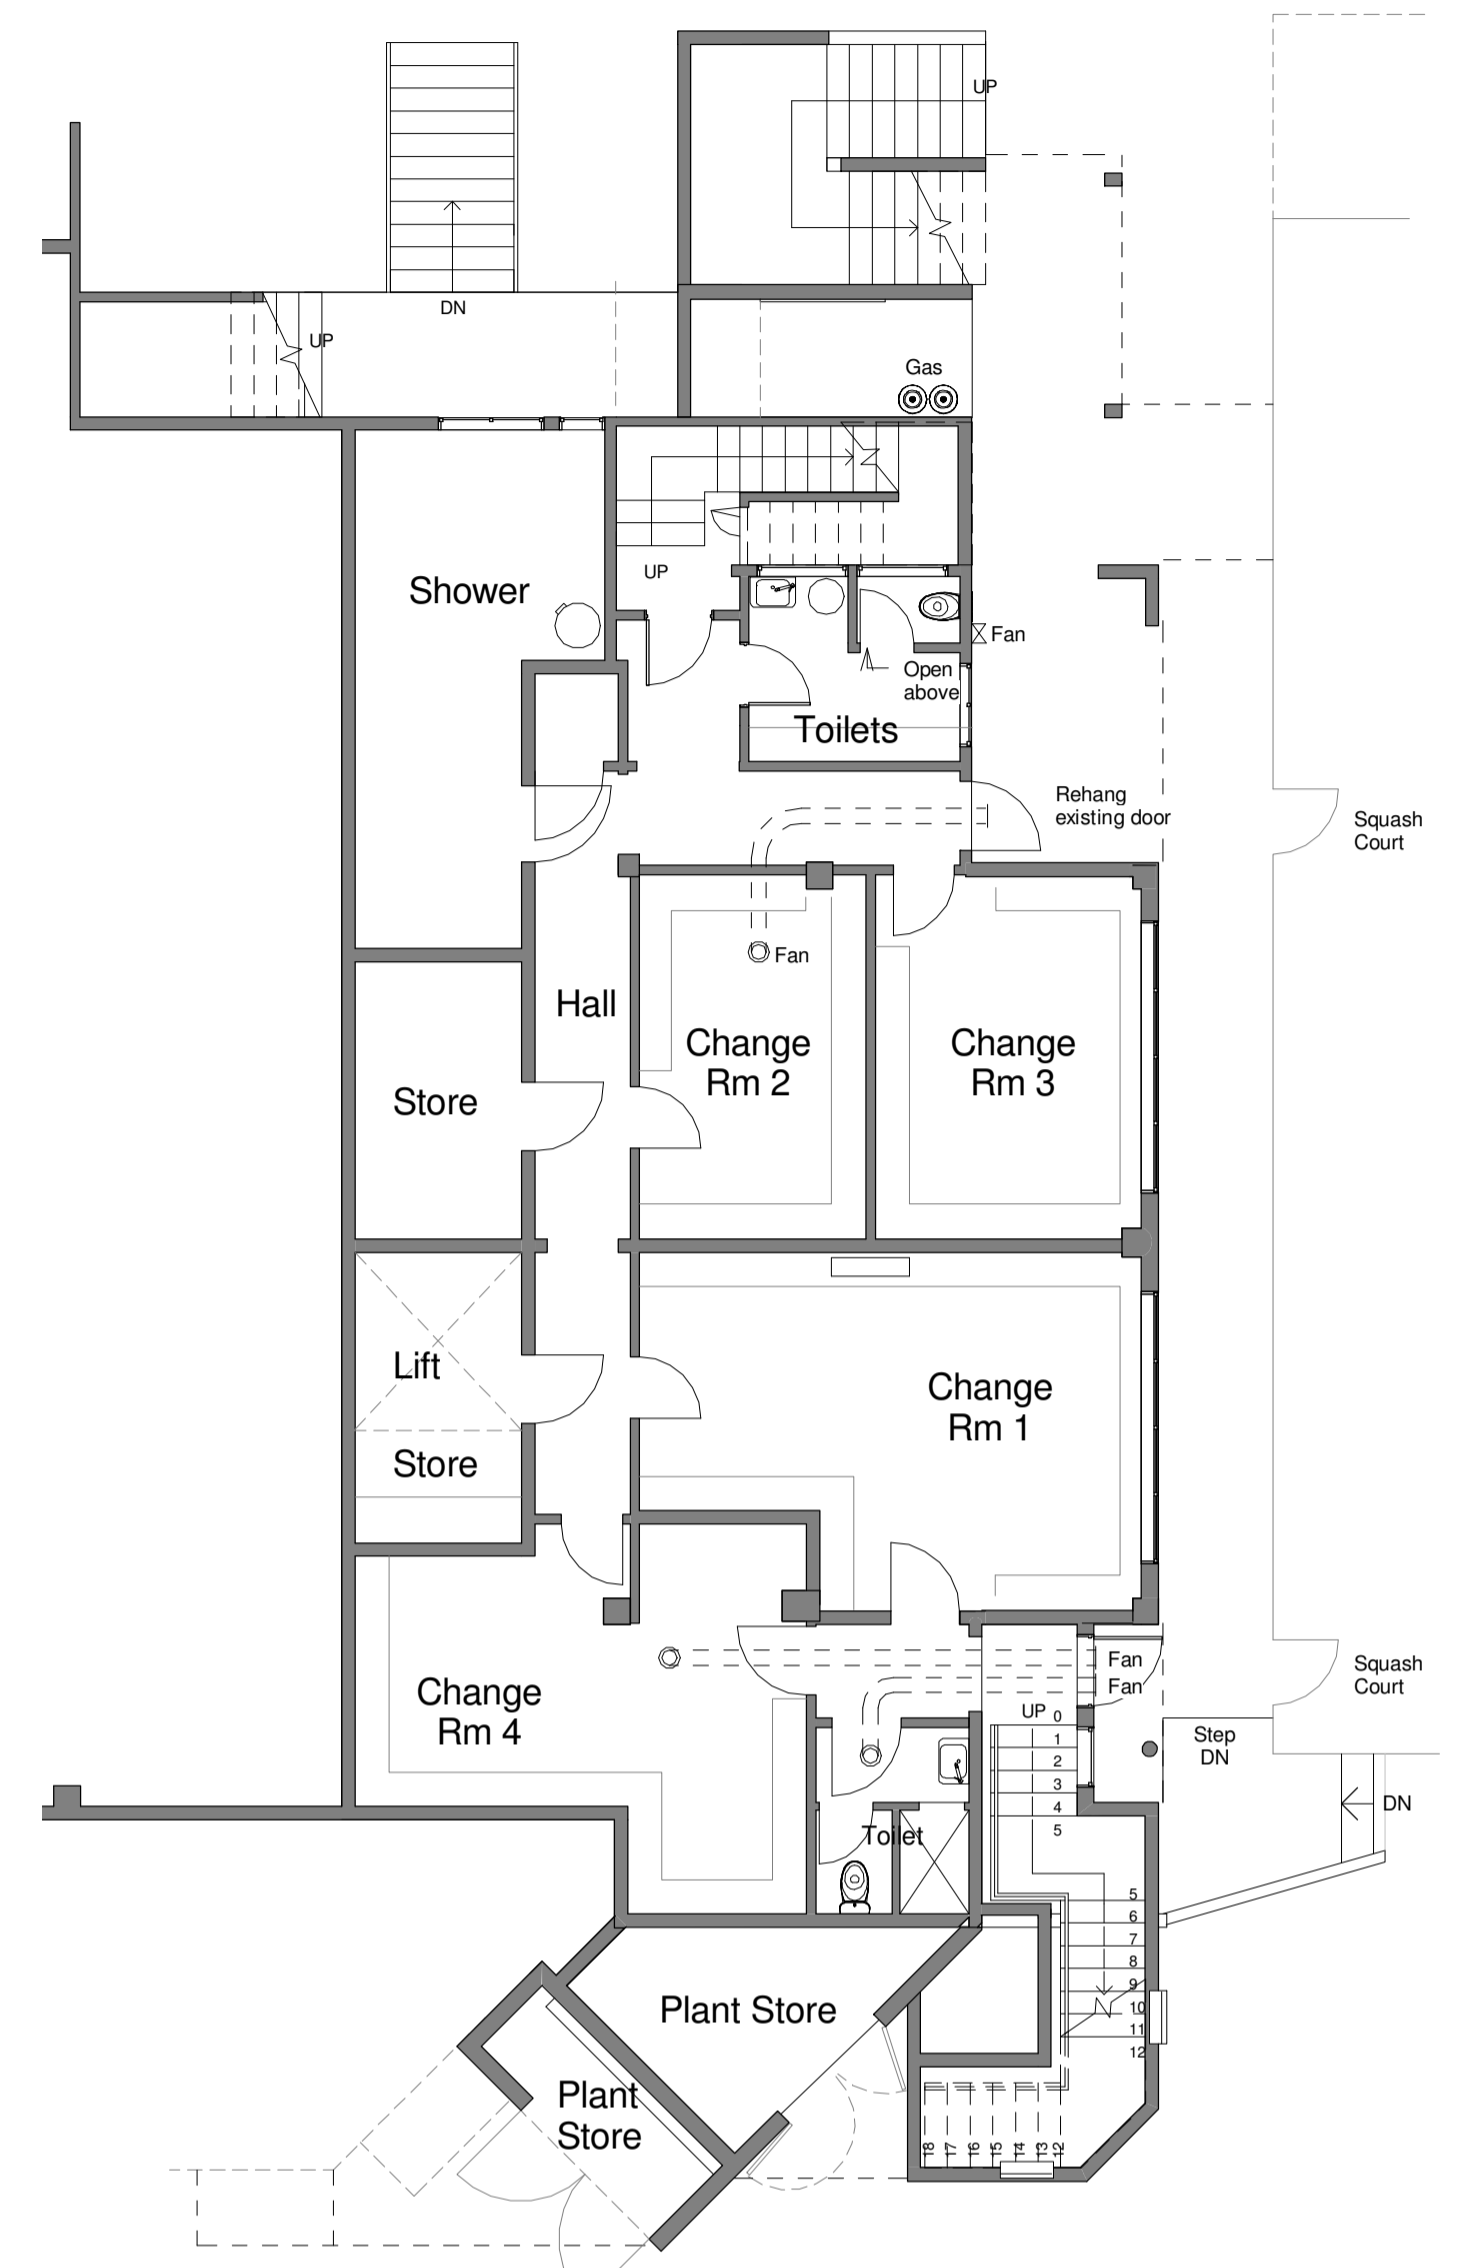

**2 Basement**  
1 : 100

1. As Built	NT	08.03.2013
2. General updates	NT	29.02.2012
3. General updates	NT	17.02.2012
4. General updates	NT	06.12.2011
5. General updates	NT	06.12.2011

Dimensions - Confirm all dimensions and profiles with Architectural Details. Do not scale.  
 If you are not sure about anything on this sheet please ask. Remember we are only as far away as the nearest telephone.  
 The Contractor shall verify all dimensions before commencing any work.  
 Copyright. In all drawings specifications and other documents and in the work executed from them remains the property of Noel Tapp Designs Consultants

Designer  
**NOEL TAPP**  
 DESIGNS  
 NZCD 4178  
 Ph: 03 442 9136 ARCHITECTURAL DESIGNERS

Project  
**MEMORIAL HALL**  
 As Built Plans  
 Memorial Centre

Designed : NT	Checked : -
Drawn : -	Approved : -
Date : March 2013	Scale : 1 : 100 @A1
Project No. 1109	Drawing No. - Printed 8/03/2013 10:53:13 a.m.